
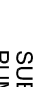
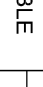
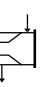
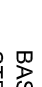

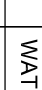

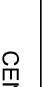



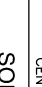







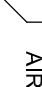
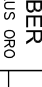
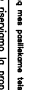

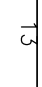




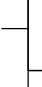



<p>LEGEND</p> <p>LEGENDA</p>	 <p>SUBMERSIBLE PUMP</p>	 <p>PACHYMASTIS SURLUVS</p>	 <p>HORIZONTAL AIR SCRUBBER</p>
 <p>BASKET STRAINER</p>	 <p>STYRMASTIS VALMD FILTRAS</p>	 <p>CENTRIFUGAL PUMP</p>	 <p>SOLENOID VALVE</p>
 <p>ELECTROVALVES</p>	 <p>HORIZONTAL AIR SCRUBBER</p>	 <p>HORIZONTAL AIR SCRUBBER</p>	 <p>HORIZONTAL AIR SCRUBBER</p>
 <p>HORIZONTAL AIR SCRUBBER</p>	 <p>HORIZONTAL AIR SCRUBBER</p>	 <p>HORIZONTAL AIR SCRUBBER</p>	 <p>HORIZONTAL AIR SCRUBBER</p>
 <p>HORIZONTAL AIR SCRUBBER</p>	 <p>HORIZONTAL AIR SCRUBBER</p>	 <p>HORIZONTAL AIR SCRUBBER</p>	 <p>HORIZONTAL AIR SCRUBBER</p>
