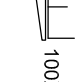

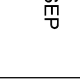
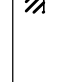
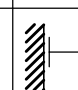

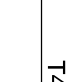

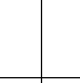
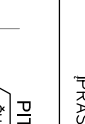
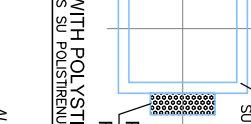


[illegible]

|  |  |  |
|--|--|--|
| T0   | T1   | T2   |
| <br>10007/5-SEP | <br>30007/5-SEP | <br>30007/5-SEP |
| T4   | T5   | T6   |
| <br>50007/5-SEP | <br>10007/5-SEP | <br>50007/5-SEP |
| T7   | T8   | T9   |
| <br>10007/5-SEP | <br>30007/5-SEP | <br>50007/5-SEP |

|   |                      |
|---|----------------------|
| <p><b>7500 PIT</b></p> <p><b>PERISTALTIC VALVES</b></p>  <p>PIT</p> <p>Stations</p>  | <p><b>LEADFO</b></p> |
| <p><b>1000 PIT</b></p> <p><b>PERISTALTIC VALVES</b></p>  <p>PERISTALTIC VALVES</p> <p>PORT VALVEMENT FOR</p> <p>PORT VALVEMENT FOR</p> <p>VALVEMENT FOR PORT VALVEMENT</p> | <p><b>LEADFO</b></p> |
|                                     |                            |        |            |
|-------------------------------------|----------------------------|--------|------------|
|                                     |                            | T.A.   | 17/10/2016 |
| 2                                   | AQUARIU<br>karp potostoyas | MCO    | 1028.2016  |
| 1                                   | Lusani<br>Ampurja          | MCO    | 09.12/2016 |
| 0                                   | BSEBO<br>SLESTA            | MCO    | 09.12/2016 |
| 00000                               | (000000)      00000000     | 000000 | 000        |
| POLSKA                              |                            |        |            |
| DOSTAWCA<br>PRACOWNIA<br>PROJEKTOWO |                            |        |            |

NOTE: ALL ELECTRICAL CORRUGATED PIPES, UNDERGROUND AND PITS ARE SUPPLIED AND INSTALLED BY CLIENT. THE ELECTRICAL WIRES INSIDE THE CORRUGATED PIPES ARE SUPPLIED AND INSTALLED BY ATZMANGHER PAISTABA. VISIŖS GORFONŖS POZEMINIUS ELEKTROS ABELIU VAMZDZUS IR ŠALINIS TEIKA IR MONITORU ALIENIUS ELEKTROS LAIDUS. ESMONIS GORFONTOUSE VAMZDUOSE, TEIKA IR MONITORU ATZMANGHER PAISTABA.