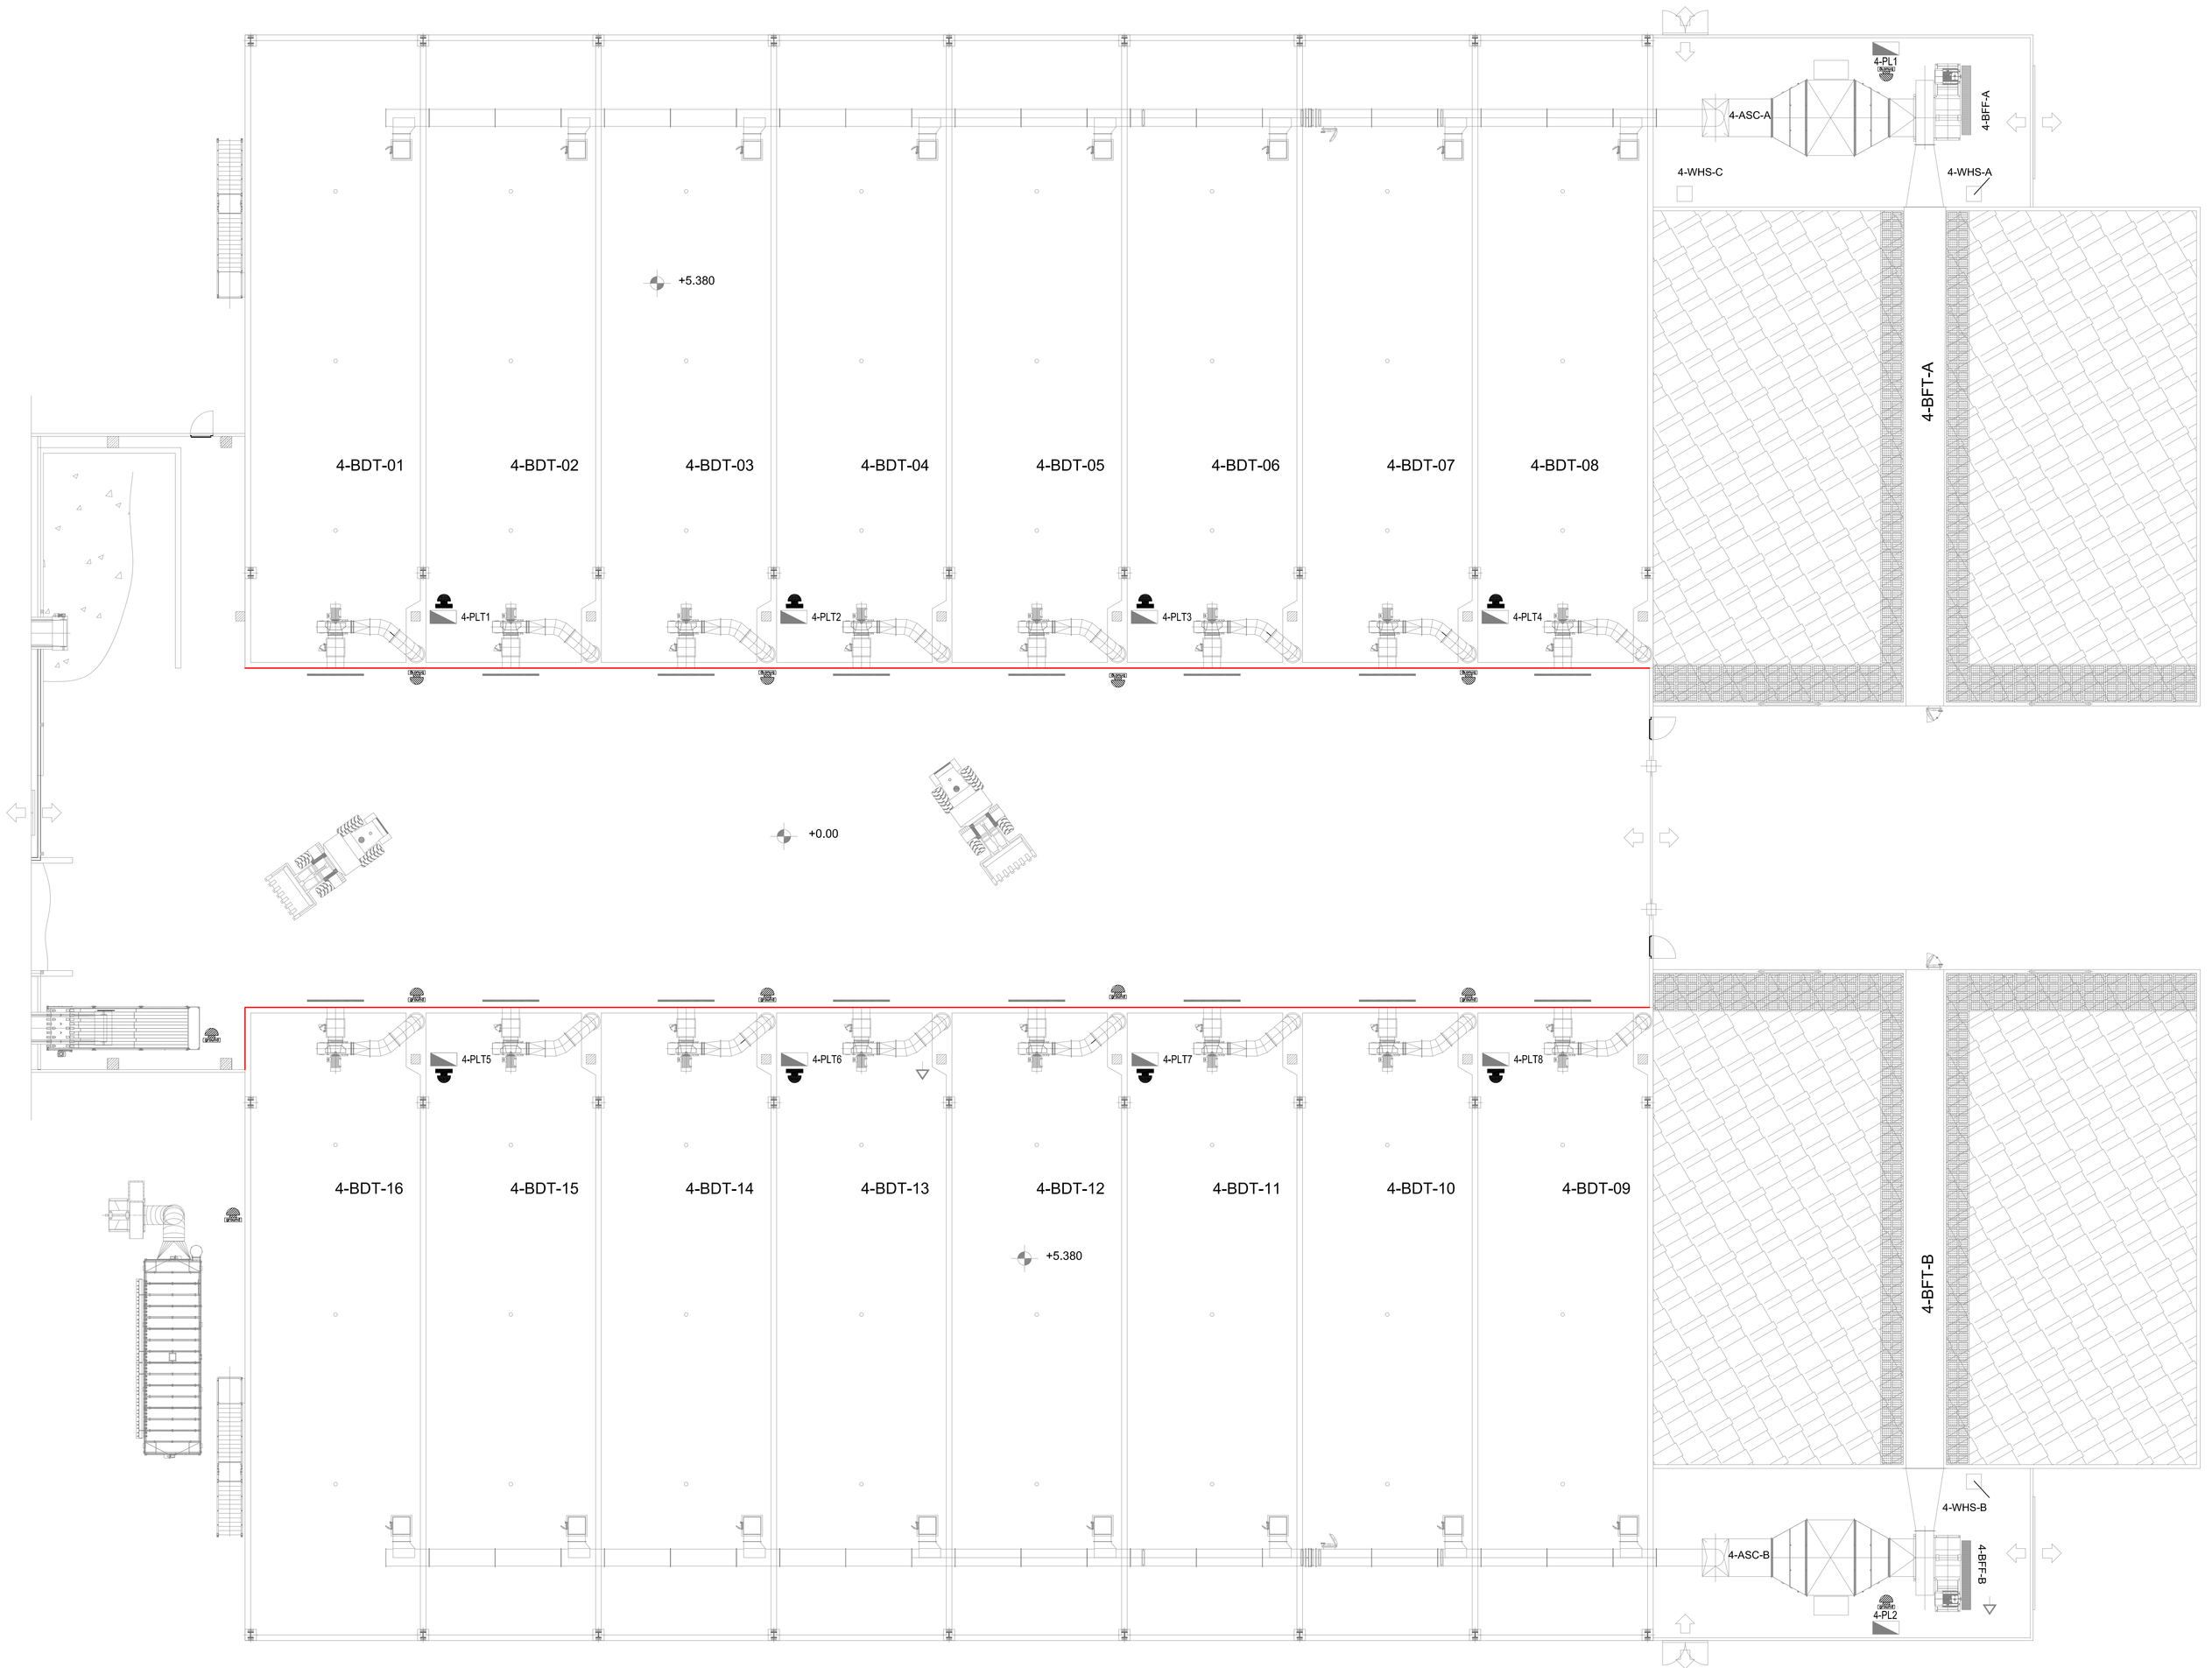

Legend: legenda

- Emergency push button on ground - Avarinio mygtukas ant žemės
- Emergency bush button under the roof - Avarinis bush mygtuką po stogu-
- Emergency pull cord on conveyors - Avarinis traukti laivu konvejeriai

Emergency push button according standard UNI EN620
Avarinio mygtukas pagal standarto UNI EN620

REVISION	DESCRIPTION	DESIGNER	DATE
1	AS BUILT	T.N.	23.11.2015
0	ISSUED	MCO	12.01.2015

DESIGNER

SUBJECT: VILNIUS MBT PLANT

TITLE: EMERGENCY DEVICES ON FIELD -BDT AREA

PROJECT NR.	DRAWING NR.	SHEET	FOLLOW	SCALE	CAD ARCHIVE
E00035	ELE-A-010	F2	-	1:200	E00035-ELE-A-010

ATZWANGER
Ecomaster Atzwanger Division
LADURNER UMWELTTECHNIK - ECOLOGIA

A termini di legge riserviamo la proprieta' di questo disegno con divieto di riprodurlo o di renderlo comunque noto a terzi senza nostra autorizzazione.
According to the law we reserve the rights to this drawing and it is forbidden to reproduce it or pass it to other parties without our approval.